


SPECIFICATION		NOTES
S.N.	TYPE	NO.
01	Hub Seating	
02	Open Workstations	
03	Private Workstations	
04	Team Rooms	
05	Meeting Rooms	
	a) Formal meeting room	
	b) Informal meeting room	
06	Casual Space	
07	Conference Room	
08	Total Open Workstations	
09	Total Private Workstations	
10	Grand Total Workstations	

NOTES
 1) THIS DRAWING IS A COPYRIGHT AND PROPERTY OF THE ARCHITECT & IS NOT TO BE PRODUCED, COPIED, HANDLED OVER TO A THIRD PARTY OR USED FOR ANY OTHER PURPOSE OTHER THAN FOR WHICH IT IS INTENDED.
 2) ALL COUNTS SHALL BE VERIFIED AT SITE.
 3) ANY DISCREPANCY SHALL BE BROUGHT TO THE NOTICE OF THE ARCHITECT.
 4) THIS DRAWING IS TO BE READ AND NOT SCALED.
 5) ALL CUSTOMIZATION REQUESTS TO BE MARKED IN THE LATEST ASBUILT DWG.

91 SPRINGBOARD
 cowork . network . grow

SUBJECT OF DRAWING:
AS BUILT LAYOUT _ JP NAGAR
3rd FLOOR

DRAWN BY :	SLASHA	DATE :	07-02-2024
REVIEWED BY :	KRISHNA	SIGN & SEAL :	

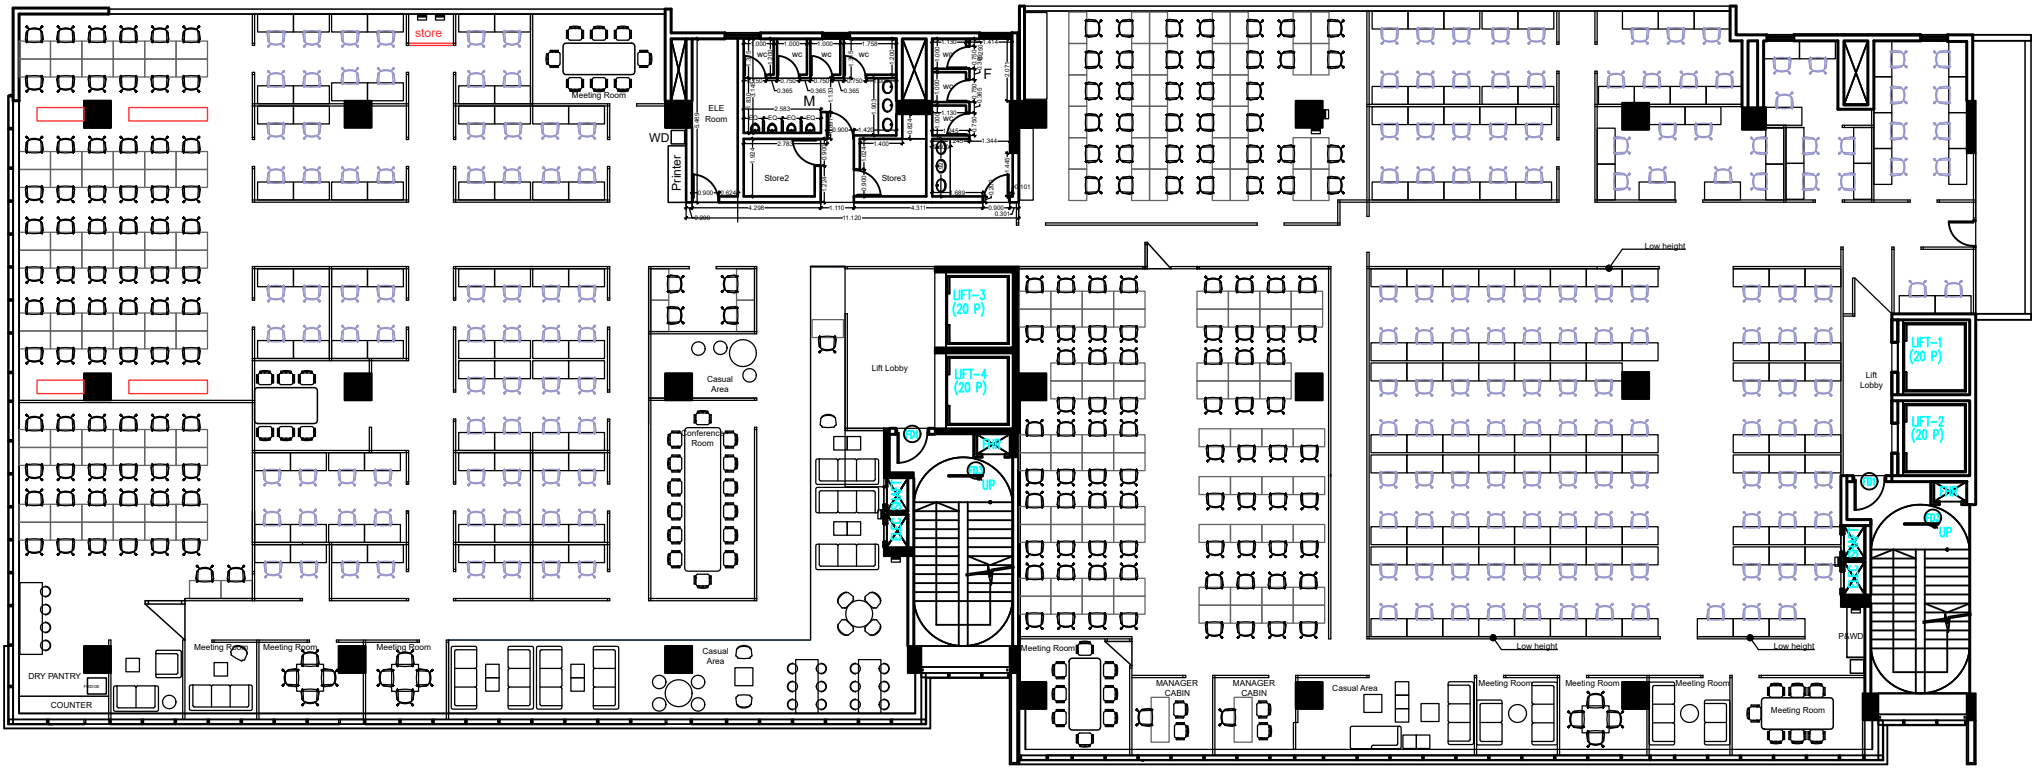


SPECIFICATION		NOTES
S.N.	TYPE	NO.
01	Hub Seating	
02	Open Workstations	
03	Private Workstations	
04	Team Rooms	
05	Meeting Rooms	
	a) Formal meeting room	
	b) Informal meeting room	
06	Casual Space	
07	Conference Room	
08	Total Open Workstations	
09	Total Private Workstations	
10	Grand Total Workstations	

THIS DRAWING IS A COPYRIGHT AND PROPERTY OF THE ARCHITECT & IS NOT TO BE PRODUCED, COPIED, HANDED OVER TO A THIRD PARTY OR USED FOR ANY OTHER PURPOSE OTHER THAN FOR WHICH IT IS INTENDED.
 ALL COUNTS SHALL BE VERIFIED AT SITE.
 ANY DISCREPANCY SHALL BE BROUGHT TO THE NOTICE OF THE ARCHITECT.
 THIS DRAWING IS TO BE READ AND NOT SCALED.
 ALL CUSTOMIZATION REQUESTS TO BE MARKED IN THE LATEST ASBUILT DWG.

91 SPRINGBOARD
 cowork . network . grow

SUBJECT OF DRAWING:
 AS BUILT LAYOUT _ JP NAGAR
 4th FLOOR

DRAWN BY :	ZUHAIR	DATE :	07/02/2024
REVIEWED BY :	KRISHNA	SIGN & SEAL :	

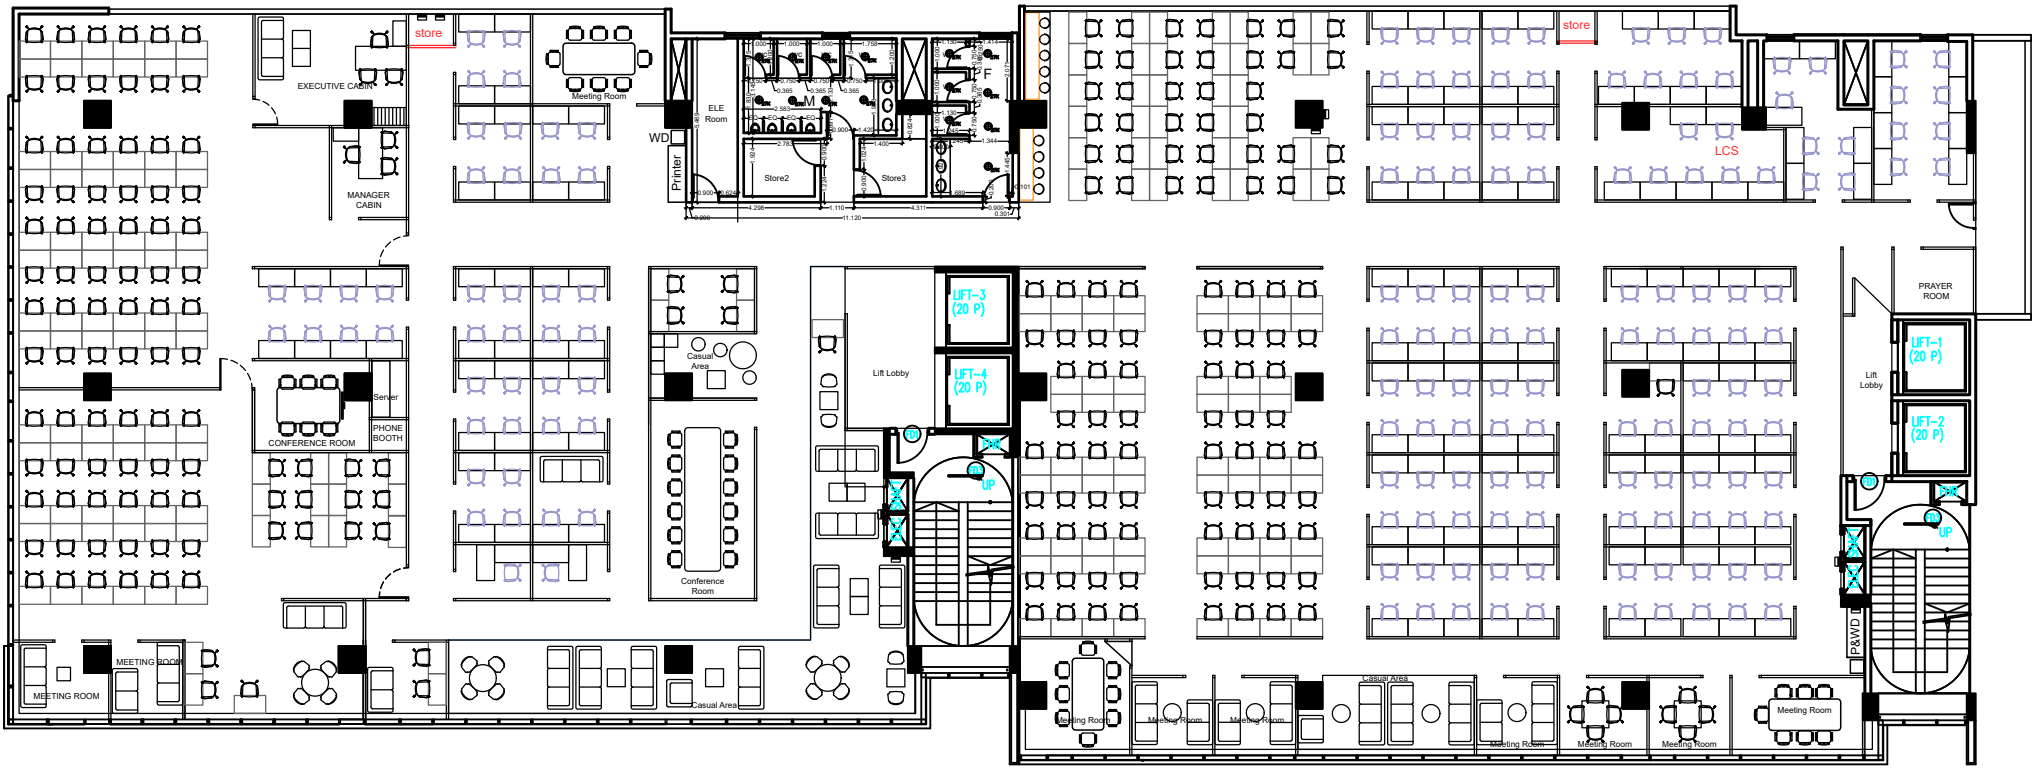


SPECIFICATION		NOTES
S.N.	TYPE	NO.
01	Hub Seating	
02	Open Workstations	
03	Private Workstations	
04	Team Rooms	
05	Meeting Rooms	
	a) Formal meeting room	
	b) Informal meeting room	
06	Casual Space	
07	Conference Room	
08	Total Open Workstations	
09	Total Private Workstations	
10	Grand Total Workstations	

THIS DRAWING IS A COPYRIGHT AND PROPERTY OF THE ARCHITECT & IS NOT TO BE PRODUCED, COPIED, HANDLED OVER TO A THIRD PARTY OR USED FOR ANY OTHER PURPOSE OTHER THAN FOR WHICH IT IS INTENDED.
 ALL COUNTS SHALL BE VERIFIED AT SITE.
 ANY DISCREPANCY SHALL BE BROUGHT TO THE NOTICE OF THE ARCHITECT.
 ALL CUSTOMIZATION REQUESTS TO BE MARKED IN THE LATEST ASBUILT DWG.

91 SPRINGBOARD
 cowork . network . grow

SUBJECT OF DRAWING:
**AS BUILT LAYOUT _ JP NAGAR
 5th FLOOR**

DRAWN BY :	ZULHAR	DATE :	07-02-2024
REVIEWED BY :	KRISHNA	SIGN & SEAL :	

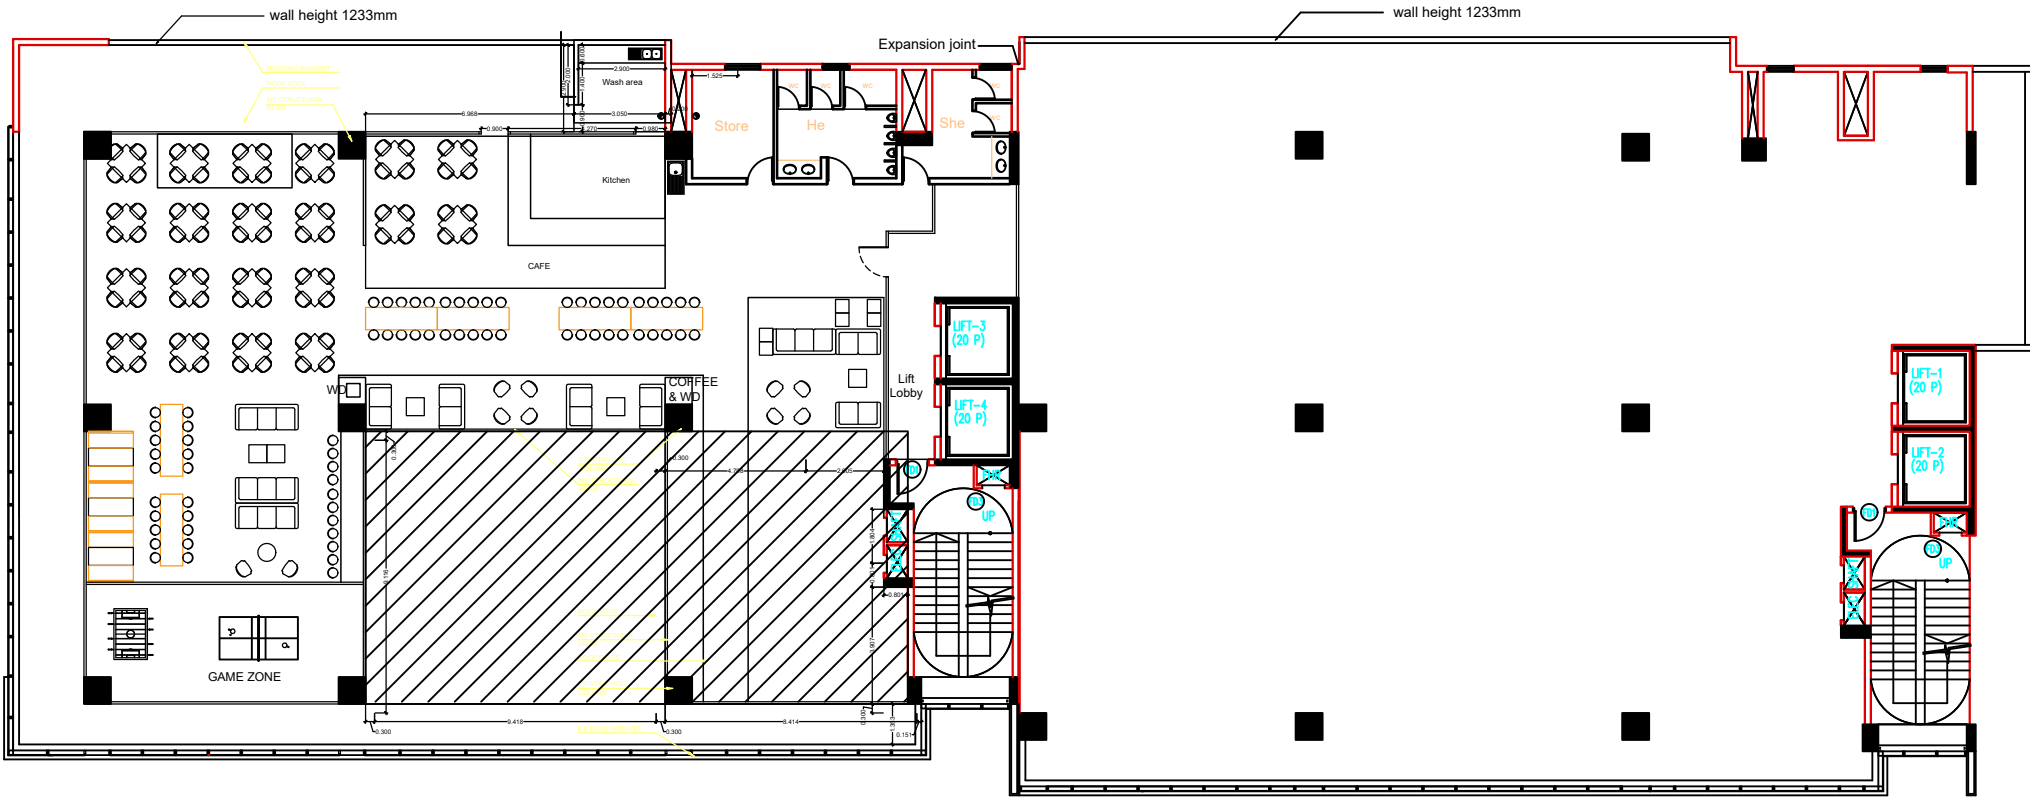

SPECIFICATION		NOTES
S.N.	TYPE	NO.
01	Hub Seating	
02	Open Workstations	
03	Private Workstations	
04	Team Rooms	
05	Meeting Rooms	
	a) Formal meeting room	
	b) Informal meeting room	
06	Casual Space	
07	Conference Room	
08	Total Open Workstations	
09	Total Private Workstations	
10	Grand Total Workstations	

THIS DRAWING IS A COPYRIGHT AND PROPERTY OF THE ARCHITECT & IS NOT TO BE PRODUCED, COPIED, HANDLED OVER TO A THIRD PARTY OR USED FOR ANY OTHER PURPOSE OTHER THAN FOR WHICH IT IS INTENDED.
 ALL COUNTS SHALL BE VERIFIED AT SITE.
 ANY DISCREPANCY SHALL BE BROUGHT TO THE NOTICE OF THE ARCHITECT.
 THIS DRAWING IS TO BE READ AND NOT SCALED.
 ALL CUSTOMIZATION REQUESTS TO BE MARKED IN THE LATEST ASBUILT DWG.

91 SPRINGBOARD
 cowork . network . grow

SUBJECT OF DRAWING:
AS BUILT LAYOUT _ JP NAGAR TERRACE FLOOR

DRAWN BY : ZAHAR	DATE : 07-02-2024	SIGN & SEAL
REVIEWED BY : KRUSHAL		