
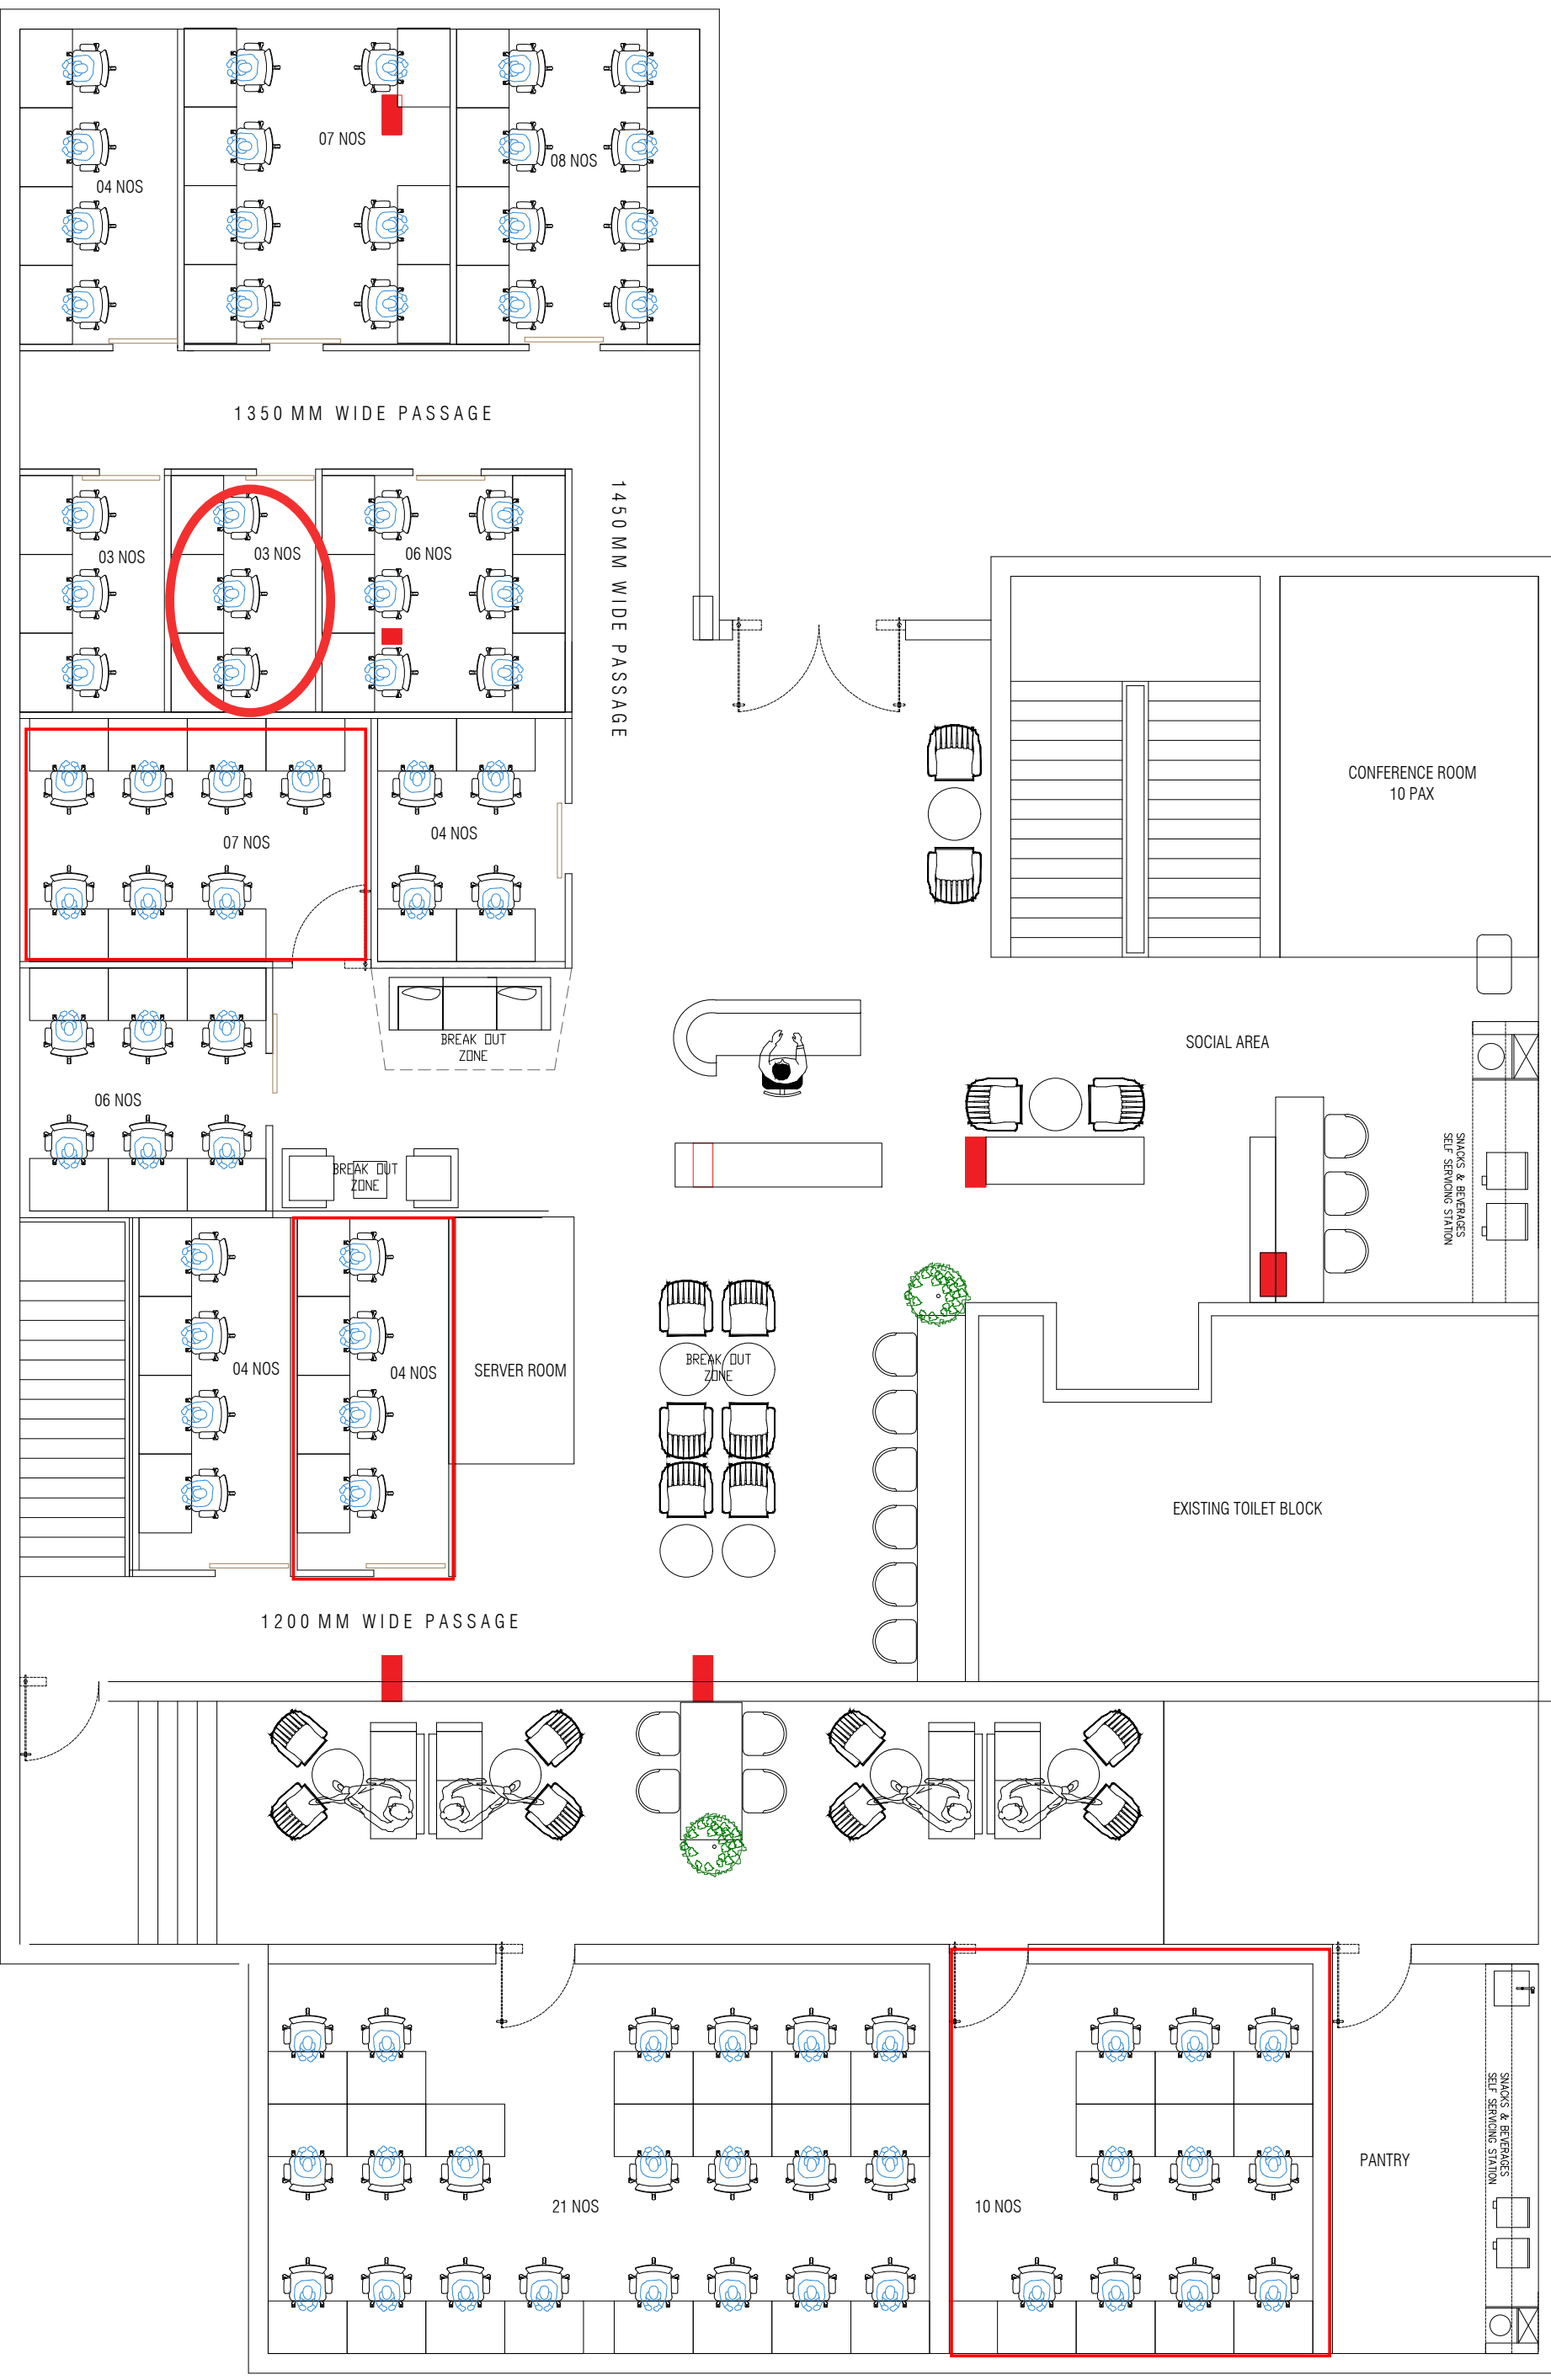


TOTAL OCCUPANCY- 107 PAX


<input checked="" type="radio"/>	FOR REFERENCE
<input type="radio"/>	FOR APPROVAL
<input type="radio"/>	FOR ESTIMATION
<input type="radio"/>	FOR TENDER
<input type="radio"/>	FOR CONSTRUCTION
<input type="radio"/>	AS-BUILT
PROJECT NAME :	
CO-WORKING SPACE MOHAN COOPERATIVE, NEW DELHI	
DESIGN CONSULTANTS :	
 <small>SHEDE 7 GOVIND PURI, NEAR C.I.A. CHOKI GHISIA PHASE 2, NEW DELHI - 110019, Ph. 9910314199</small>	
DRAWING TITLE :	
PROPOSED LAYOUT	
DRAWING NUMBER :	DL/CR/00/01
DRAWN BY :	MANOJ
CHECKED BY :	JASPREET
APPROVED BY :	
SCALE :	NTS
DATE :	03.05.22
REV NO.:	R-02

BASEMENT FLOOR PLAN



TOTAL OCCUPANCY- 89 PAX


GROUND FLOOR PLAN

<input checked="" type="radio"/>	FOR REFERENCE
<input type="radio"/>	FOR APPROVAL
<input type="radio"/>	FOR ESTIMATION
<input type="radio"/>	FOR TENDER
<input type="radio"/>	FOR CONSTRUCTION
<input type="radio"/>	AS-BUILT
PROJECT NAME :	
CO-WORKING SPACE MOHAN COOPERATIVE, NEW DELHI	
DESIGN CONSULTANTS :	
 <small>SHEDE 7 GOVIND PURI, NEAR C.I.A. CHOKI GHATA PHASE 2, NEW DELHI - 110019, Ph. 9910314199</small>	
DRAWING TITLE :	
PROPOSED LAYOUT	
DRAWING NUMBER :	DL/GR/00/01
DRAWN BY :	MANUJ
CHECKED BY :	JASPREET
APPROVED BY :	
SCALE :	NTS
DATE :	03.05.22
REV NO.:	R-02



TOTAL OCCUPANCY- 150 PAX


FIRST FLOOR PLAN

<input checked="" type="radio"/>	FOR REFERENCE
<input type="radio"/>	FOR APPROVAL
<input type="radio"/>	FOR ESTIMATION
<input type="radio"/>	FOR TENDER
<input type="radio"/>	FOR CONSTRUCTION
<input type="radio"/>	AS-BUILT
PROJECT NAME :	
CO-WORKING SPACE MOHAN COOPERATIVE, NEW DELHI	
DESIGN CONSULTANTS :	
 <small>SHEKHAR 7 GOVIND PURI, NEAR C.I.A. CHOKI, CHOKI PHASE 2, NEW DELHI - 110019, Ph. 9910314199</small>	
DRAWING TITLE :	
PROPOSED LAYOUT	
DRAWING NUMBER :	DL/CR/00/01
DRAWN BY :	MANOJ
CHECKED BY :	JASPREET
APPROVED BY :	
SCALE :	NTS
DATE :	02.05.22
REV NO. :	R-02



TOTAL OCCUPANCY- 127 PAX

SECOND FLOOR PLAN

<input checked="" type="radio"/>	FOR REFERENCE
<input type="radio"/>	FOR APPROVAL
<input type="radio"/>	FOR ESTIMATION
<input type="radio"/>	FOR TENDER
<input type="radio"/>	FOR CONSTRUCTION
<input type="radio"/>	AS-BUILT
PROJECT NAME :	
CO-WORKING SPACE MOHAN COOPERATIVE, NEW DELHI	
DESIGN CONSULTANTS :	
 <small>5802/7 GOVIND PURI, NEAR C.I.A. CHOKI, OKHA PHASE 2, NEW DELHI - 110019, Ph. 9910314199</small>	
DRAWING TITLE :	
PROPOSED LAYOUT	
DRAWING NUMBER :	DL/CR/00/01
DRAWN BY :	MANOJ
CHECKED BY :	JASPREET
APPROVED BY :	
SCALE :	NTS
DATE :	03.05.22
REV NO.:	R-02